

Valid upto 31.12.25

GOVERNMENT OF TRIPURA  
OFFICE OF THE MEMBER SECRETARY  
DSBMMC  
UNAKOTI DISTRICT: KAILASHAHAR

No.F.1(33)/MS/DSBMMC/U/2022-23/10418

Dated, Kailashahar  
The 05 / 01 / 2023

**STRUCTUTAL FITNESS CERTIFICATE**

**Name of Building/ Structure:** - Holy Cross School Building Kumarght.

**Location:** - Pabiacherra.

**Reference:** - Letter No. nil, dated 04/01/2023 of the Principal, Holy Cross School,  
Kumarghat.

This is to certify that the school building has been inspected physically on 04/01/2023 and nothing has been noticed that affect adversely to the fitness of structure. This is a frame structure building and appears to be fit. The building was constructed in the year 2009 as reported by the authority of school. It is noteworthy to mention that this fitness certificate is issued on visual inspection & valid up to 31/12/2025. only.

05/01/2023

(Er. S.A. Hussain)  
Executive Engineer  
Member Secretary  
DSBMMC  
Unakoti District, Kailashahar

To

✓ The Principal  
Holy Cross School  
Pabiacherra, Kumarghat  
Unakoti Tripura.

Prescribed Format of Self-Certification:

Non-Deviation & fulfilling the terms and conditions  
(To be filed by the Owner/Occupier/Authorized Signatory on anon-judicial  
stamp paper, affidavit by First Class Judicial Magistrate or at least  
Notarized)  
[Residential/Non-residential]

**Self-Certification**  
(Before issuance of Final NOC)

I, **J. SAHAYA LOURDU RAJ**, S/O S. Joseph as Owner/Occupier/ Authorized Signatory of Mr. **J. SAHAYA LOURDU RAJ**, located at Kumarghat bearing Dag/Holding No: 3444, 3447 Ward No: 10 District Unakoti do hereby state as under:-

- 1) That, it is declared that I have complied all the safety recommendation vide your Office Letter No: FSRTFES/2022/00249, Dated: 09/03/2023
- 2) In this connection it is also submitted that-
  - a) There is no change in trade for which license has been issued (For Non-Residential).
  - b) There is no any structural change of the Building either horizontally or vertically affecting means of Escapes/Exits.
  - c) There is no any change in existing Fire Fighting arrangement.
  - d) Fire Prevention & Fire Safety Measures / Arrangements have been tested and are found in good working condition.

Consequences for non-compliance

- 3) The following provisions are known to me.
  - i) Any Self-Certification, if found false or otherwise, will be treated as willful criminal negligence and shall be brought into justice under appropriate provision of prevailing law of the land.
  - ii) The owners or occupiers, as the case may be, individually or jointly, who are liable to provide fire protection and life safety measures in building or part of building or premises, who, at any time, fail to comply shall be deemed to be in default. In case, where a fire safety certificate is issued earlier shall remain suspended for a period from the date of notice for non-compliance and Fire Safety Certificate shall be cancelled after giving owner or occupier an opportunity of hearing to show-cause by following due process of law.

I/We solemnly affirm and declare that the particulars given in herein are correct to my/our knowledge belief and nothing material has been concealed by me/us therefrom.

Dated: 15-03-2023

Place : Kumarghat

Signature and seal of the applicant(s)

Name in Full :


Mobile No: 9862979965

IDENTIFIED BY

15/3/23  
Pradip Kanta De  
Advocate  
TV Bar Association  
Dhalai Tripura


15/3/2023  
Khaleduzzaman  
Notary Regd. No.-30 of 2017  
Govt. of Tripura  
Kumarghat &  
Longtharai Valley.



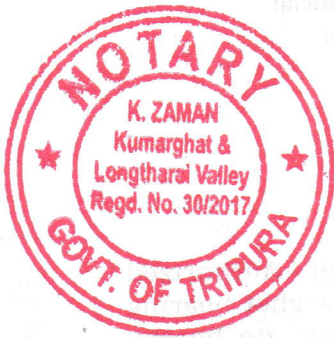


## AFFIDAVIT

Sworn Before me on the 15<sup>th</sup> 20<sup>23</sup>  
Day of March  
by J. Sahay Louren Raj s/o  
Joseph of Kumarghat  
unsuchi Tripura  
who has/have been identified by Pradip  
Ra. de advocate whose signature (s)  
is/are hereto appended at 4.20 pm

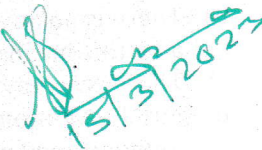  
15/3/2023


Khaleduzzaman  
Notary Regd. No.-30 of 2017  
Govt. of Tripura  
Kumarghat &  
Longtharai Valley.

IDENTIFIED BY

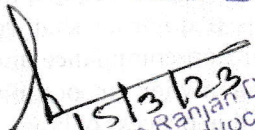  
15/3/23  
Pradip Ranjan De  
Advocate  
TV Bar Association  
Dhalai Tripura




HOLY CROSS SCHOOL KUMARGHAT

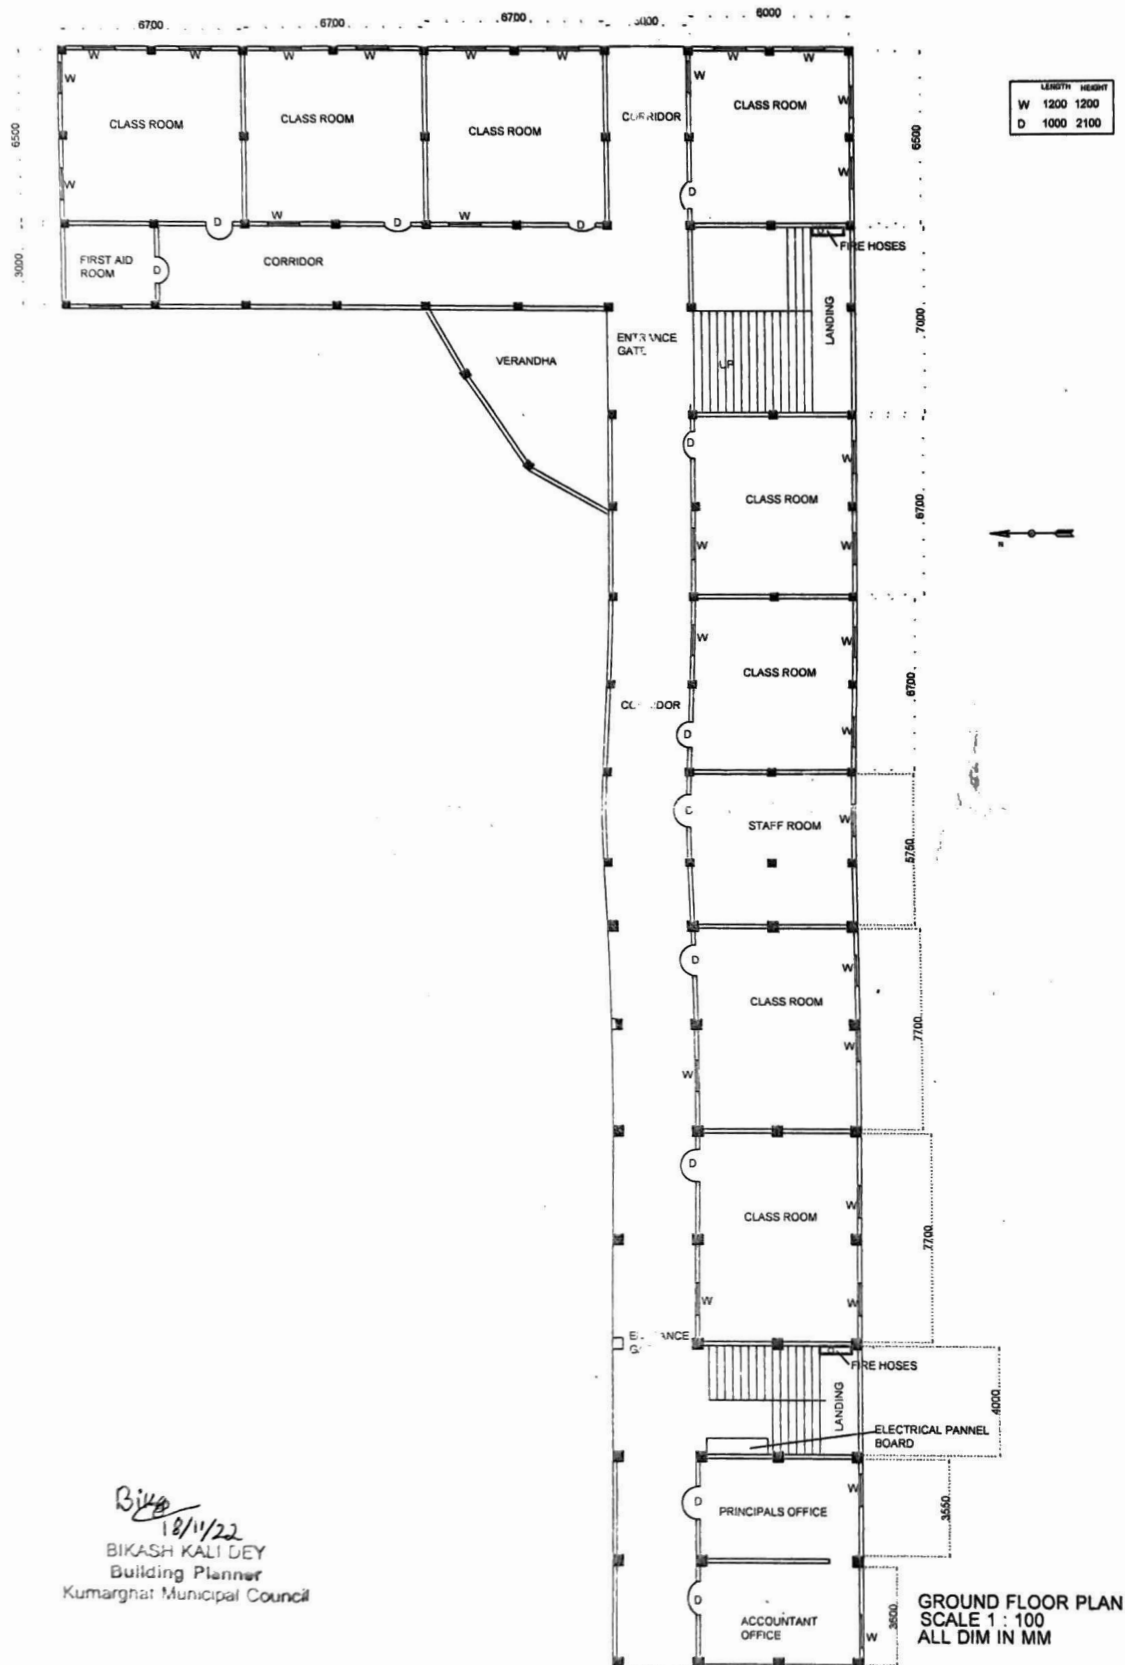

BIKASH KALI DEY  
Building Planner  
Kumarghat Municipal Council

GROUND FLOOR PLAN  
SCALE 1 : 100  
ALL DIM IN MM

HOLY CROSS SCHOOL KUMARGHAT

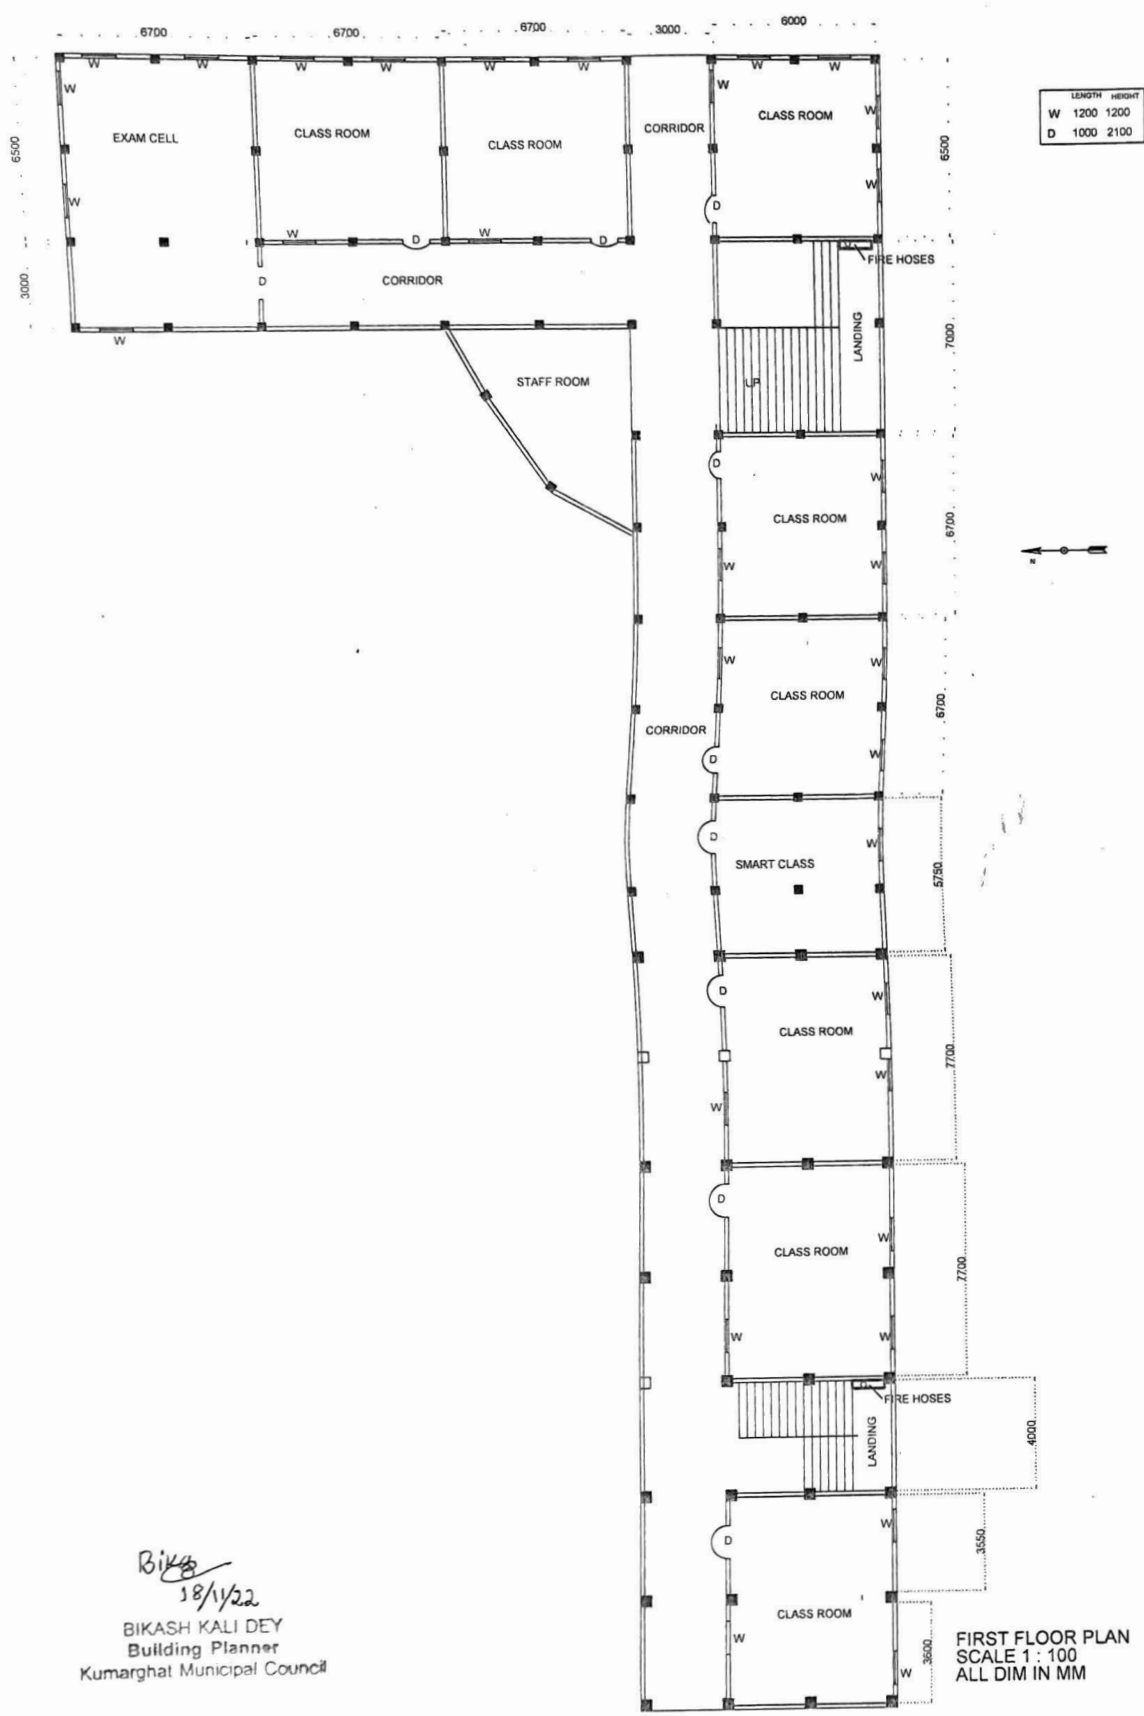

BIKASH KALI DEY  
Building Planner  
Kumarghat Municipal Council

FIRST FLOOR PLAN  
SCALE 1 : 100  
ALL DIM IN MM

HOLY CROSS SCHOOL KUMARGHAT

